


EXAMPLE OF LOCATION
OF VALVES, FITTINGS AND
HYDRANTS FOR AS-BUILT
DRAWINGS

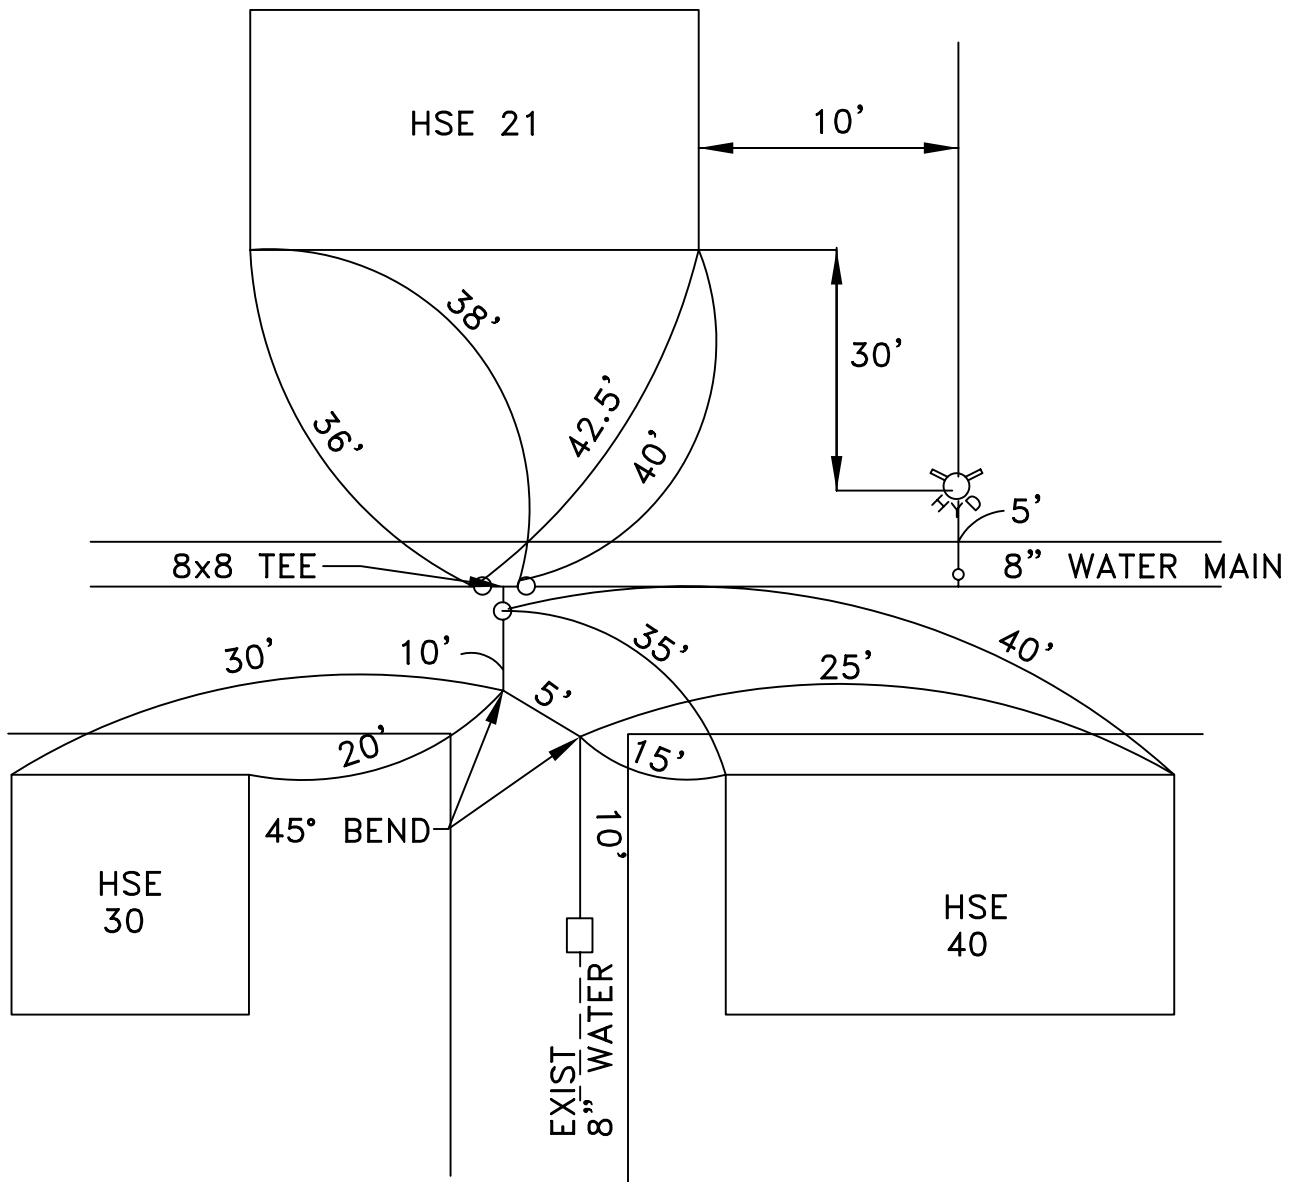

KENT COUNTY WATER AUTHORITY

AS-BUILT EXAMPLE FOR WATER MAINS

KCWA

"proudly serving"

NOT TO SCALE

DATE: 09/2006