


EXAMPLE OF HOUSE
SERVICE AS- BUILTS

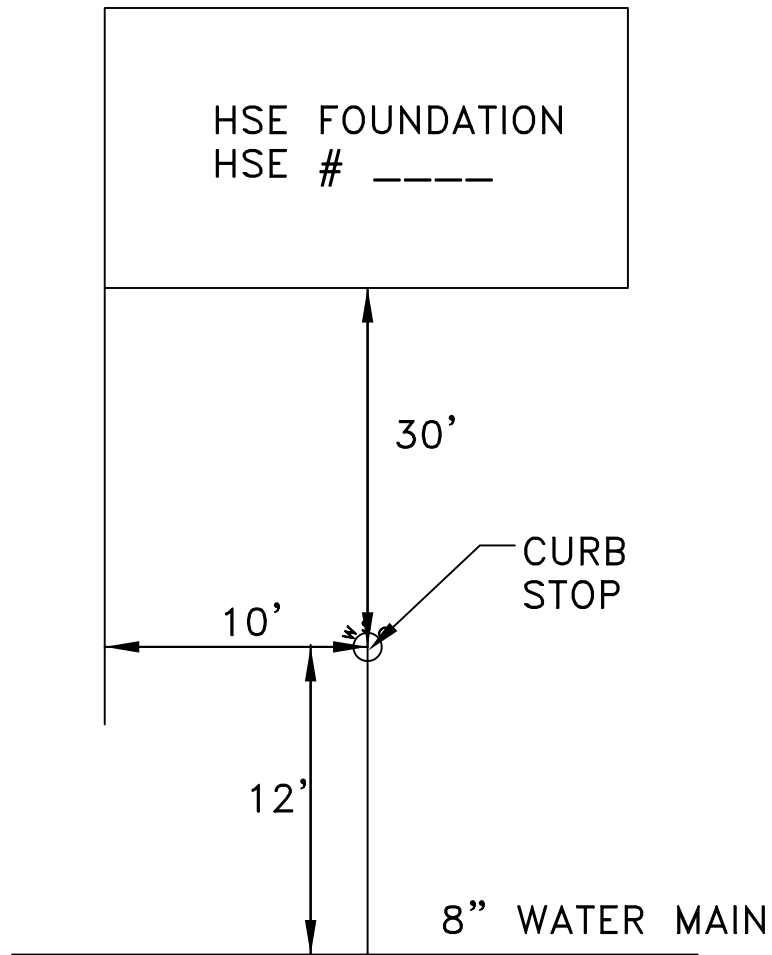

DEPTH OF MAIN = 5'
STANDARD SIZE OF SERVICE = 3/4"